


AS-BUILT CERTIFICATION
30 TAYLOR RIVER ESTATES
HAMPTON, NH
SCALE: 1"=20' SEPT 29, 2016


STOCKTON SERVICES
HAMPTON, NH

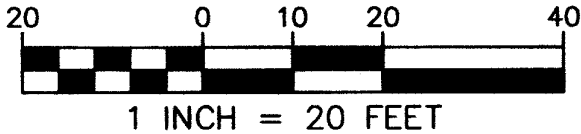

THE PURPOSE OF THIS PLAN IS TO
CERTIFY TO NEW STRUCTURE SETBACKS.
NO OTHER REPRESENTATION IS INTENDED
OR IMPLIED.

OWNER OF RECORD:
DONNA M. DEMARCO
30 TAYLOR RIVER ESTATES
HAMPTON, NH 03842

TAX MAP 184 LOT30
ZONING CLASS: G
RCL AREA: 16082 SF±
RCRD 3314-2173
RCRD PLAN D17786
RCRD PLAN D21018

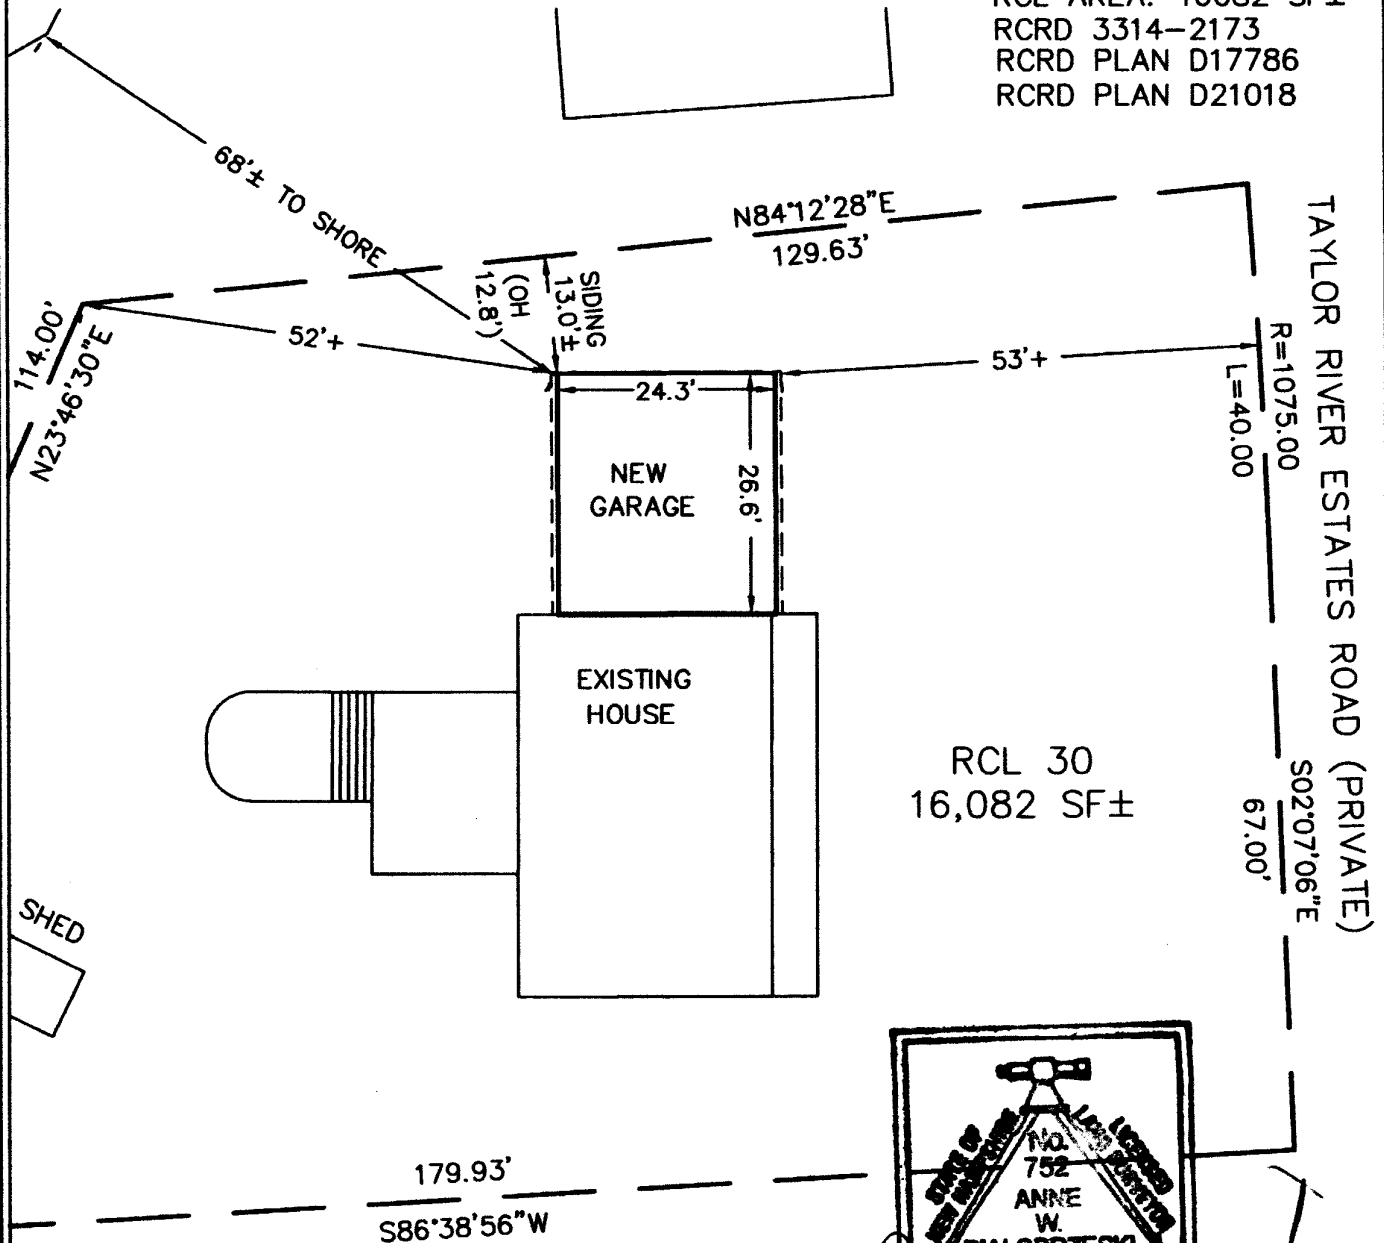

RCL 30
16,082 SF±



9/29/16

RCL AREA DOES NOT LIE WITHIN A FEDERALLY
DESIGNATED FLOOD HAZARD ZONE.

722